


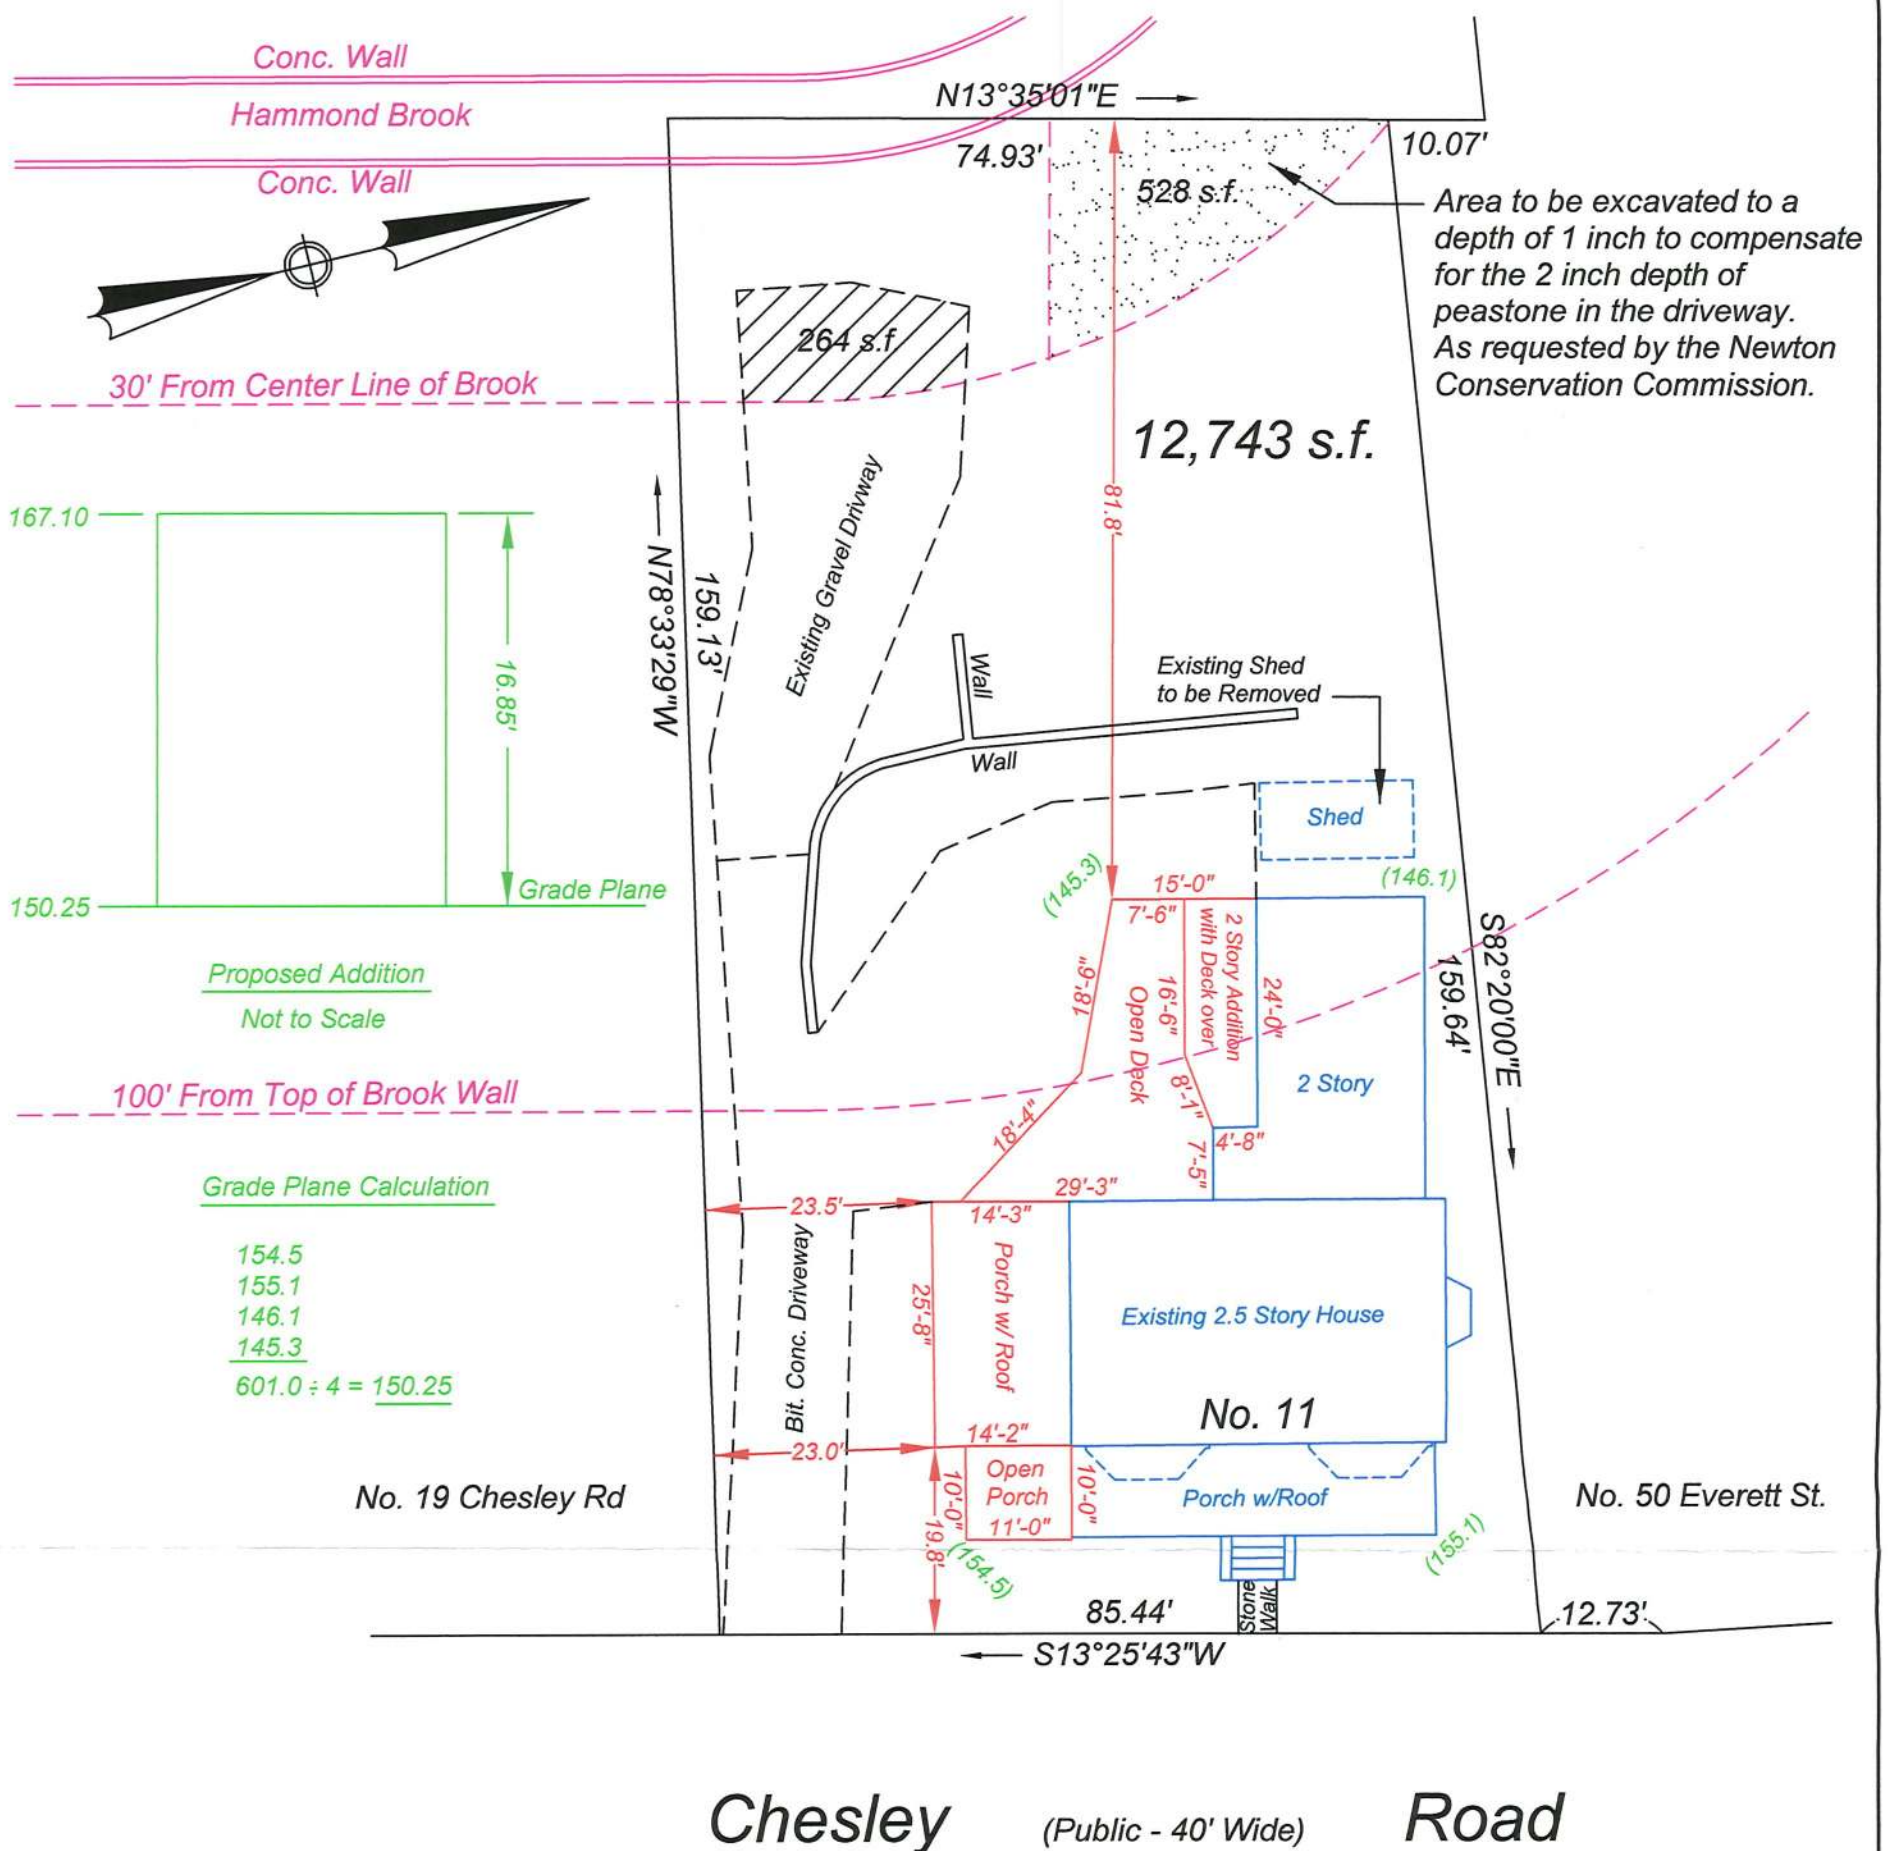

Front Setback Calculation

No. 50 Everett St.....10.50' (Actual)
No. 19 Chesley Rd.....25.00' (Required)
 $35.50 \div 2 = 17.75'$

Zone: SR-2 (Old Lot)
Lot Coverage: 20.7%
Open Space: 51.4%

Deed: Book 32,022, Page 553
Plan: Plan Book 92, Plan 32




As-Built Plan of Land

IN Newton, Massachusetts

AT 11 Chesley Road

Owned by: Ellen S. Highfield

GRAPHIC SCALE

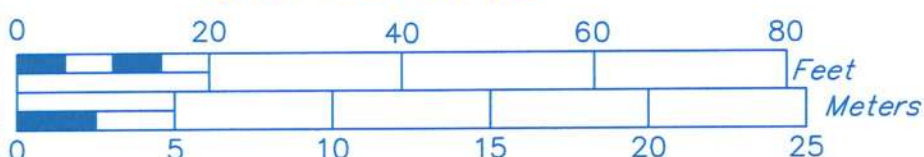

To obtain meters, multiply feet by 0.3048

Scale: 1 inch = 20.00 feet

Wade T. Putnam

12 Nutting Road

Phone (617) 924-7877

December 20, 2011

Professional Land Surveyor

Waltham, Mass. 02451-3113

Email: rah55@comcast.net